

Lyman, Randy

From: Lyman, Randy
Sent: Friday, August 01, 2003 4:18 PM
To: Fry, Jim
Cc: Schaefer, Bob; Malter, Ed; Swarengin, Kevin
Subject: 510 E. Turner

Jim please find attached a sketch with our field crew's findings. The sketch is not to scale and their estimations of private line locations are only "guestimations". Dye was placed in cleanouts on the 2258 N. Benton Ave. property and it surfaced in puddles on the west side of 510 E. Turner. It appears all three properties have separate lines to the City sewer shown in green. Can you send a notice to 2258 N. Benton to repair/clean their line to prevent surfacing sewage on the 510 E. Turner property? It may be a civil matter they will have to work out themselves. Our TV crew said there appears to be roots coming into the city line from all three residential connections.



510ETURNER.bmp

Randy Lyman
Pretreatment Coordinator
City of Springfield, Mo.
1216 W. Nichols St.
Springfield, Mo. 65802
417-864-1487 phone
417-864-1918 fax
mailto:randy_lyman@ci.springfield.mo.us
<http://www.ci.springfield.mo.us/sanitary/pretreatment>

Tracking:

Recipient
Fry, Jim
Schaefer, Bob
Malter, Ed
Swarengin, Kevin

Read

Read: 8/4/2003 7:40 AM
Read: 8/1/2003 4:18 PM
Read: 8/1/2003 5:21 PM

510 E. TURNER

510 E.
TURNER

Swearengin, Kevin

From: Lyman, Randy
Sent: Thursday, July 31, 2003 12:14 PM
To: Swearengin, Kevin
Cc: Schaefer, Bob; Malter, Ed
Subject: 510 E. Turner


I've been involved with this for a week or two. Owner of 510 Mike Stark called a week or two ago and said a puddle of water or sewage appeared on the west side of this house, his cleanout is on east side. CU said it was not public water. We sent crew and our line was clear. Had Sharon call and give to Health. Health went out and issued him notice to fix. He called me and he dug down and found a broken pipe; said it isn't his; flushed stool, ran washer, etc. and no flow observed. Told him to have Health contact possible upstream properties and dye them to see what may be tributary. Jim Fry told him they don't do that, it is our of their responsibility to find out where it is coming from, not theirs; they can't do that. Fry said that is the sewer dept.'s responsibility. I told him we don't do stuff on private property usually. Probably won't be resolved unless we do something. Can you send TV or someone to use find the source. Health has given him official notice to fix it since it is on his property. Map indicates to me there may be a common line serving 510 and 2258 N Benton. If the Benton address's sewer is tributary, Health should be notified to send notice to Benton address as well, in my opinion. As usual, Health would just as soon we do it all, I think. Utilities show Gregory Ponder for the Benton St. house, 863-1818 and 800-952-4738.



510eturner.rtf (4
MB)


Randy Lyman
Pretreatment Coordinator
City of Springfield, Mo.
1216 W. Nichols St.
Springfield, Mo. 65802
417-864-1487 phone
417-864-1918 fax
mailto:randy_lyman@ci.springfield.mo.us
<http://www.ci.springfield.mo.us/sanitary/pretreatment>

510 E TURNER

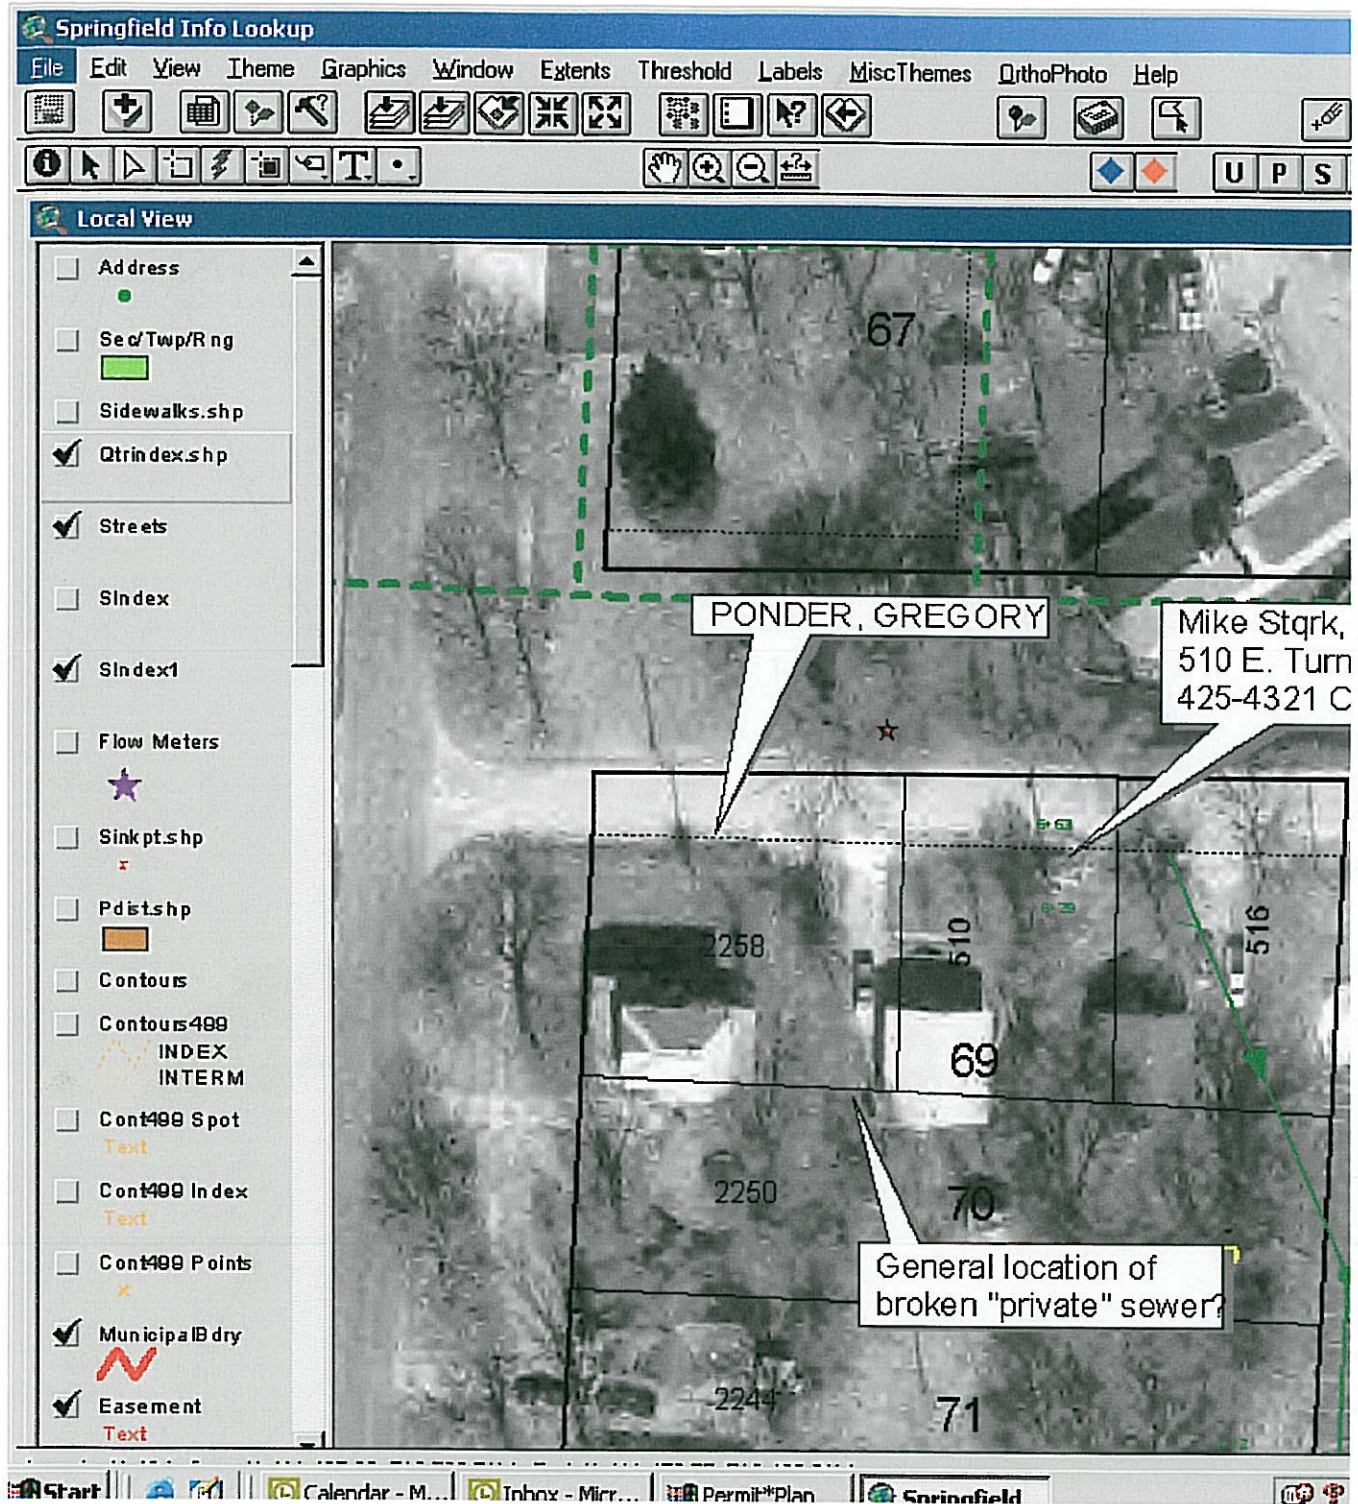

510 E. TURNER

TURNER

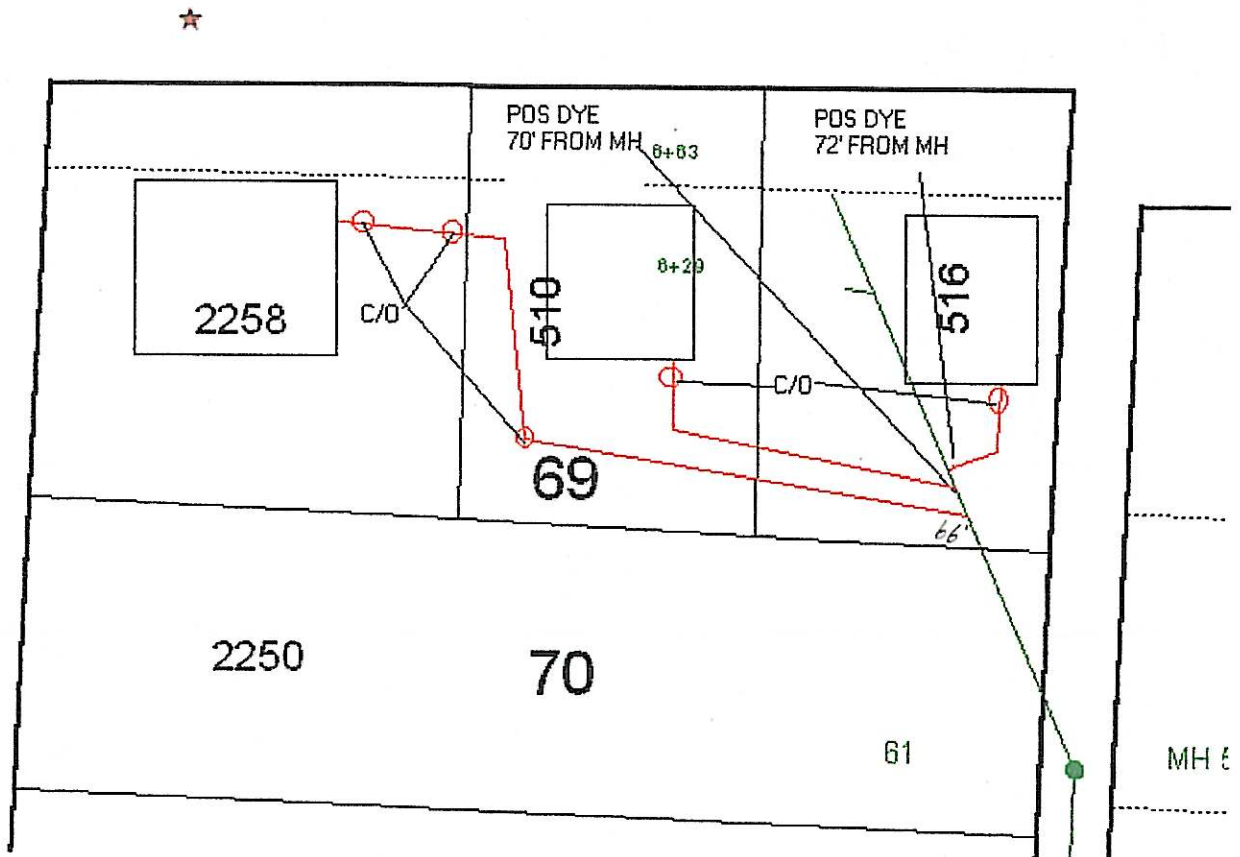

510 E. TURNER

POS DYE

DISCLAIMER: All information included on this map or digital file is provided "as is" for general information purposes only. The City of Springfield, and all other contributing data suppliers, make no warranties, expressed or implied, concerning the accuracy, completeness,




Turner St

Locations of private building sewers in red are estimations only. Actual locations were not determined.

POS DYE 70' FROM
DOWNSTREAM
MANHOLE

POS DYE
72' FROM DS

B e n t o n A y

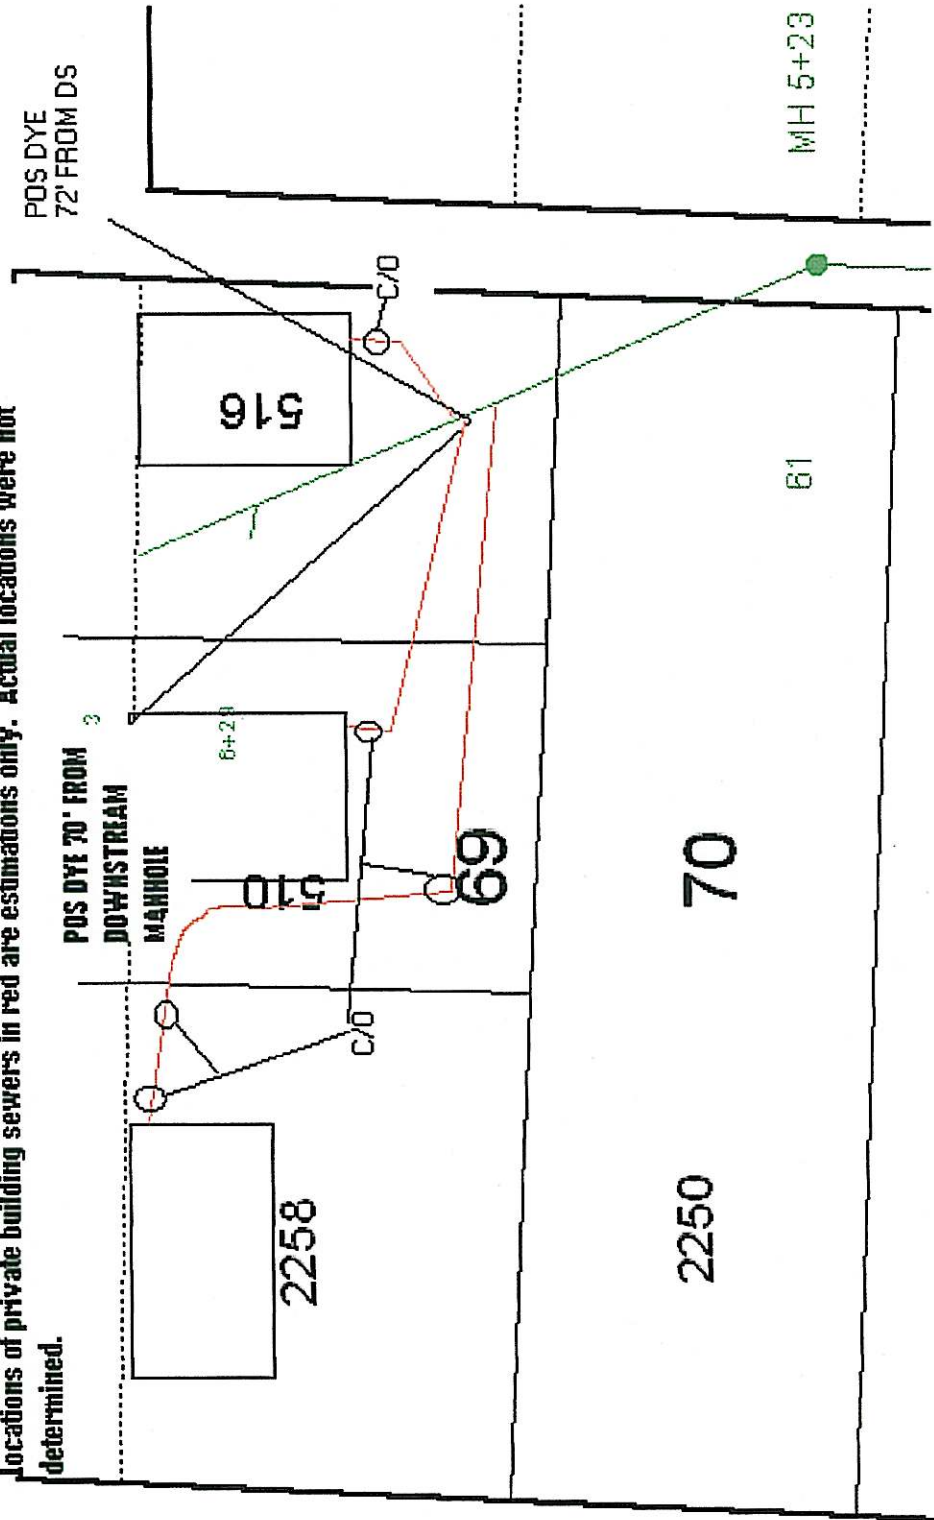

510 E. TURNER